PLANS FOR THE CONSTRUCTION OF

MONTWOOD HEIGHTS UNIT 8

ALL OF TRACT 1D, BLOCK 79
SECTION 4, TSP 3
TEXAS AND PACIFIC R.R. CO. SURVEY
CITY OF EL PASO, EL PASO COUNTY, TEXAS
CONTAINING 22.064 ACRES

MONTWOOD HEIGHTS UNIT 8

Good Set

VICINITY MAP

SCALE: NTS

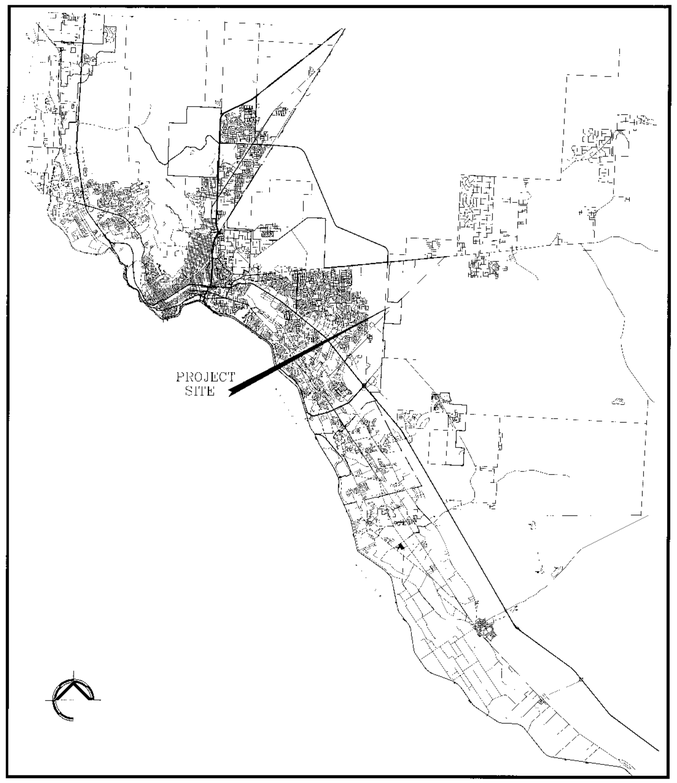

LOCATION MAP

SCALE: 1"=600'

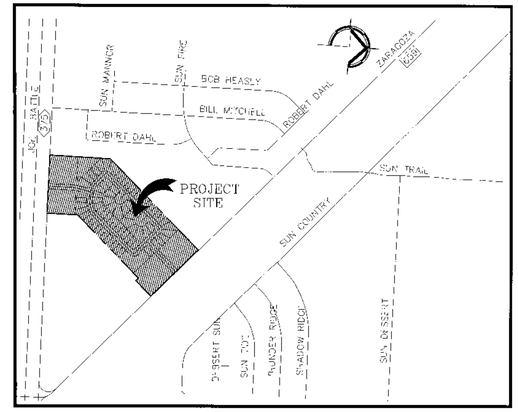

INDEX TO SHEETS

1.	COVER SHEET
2.	FINAL PLAT
3.	GRADING PLAN
3.1	GRADING CROSS SECTIONS
4.	DRAINAGE PLAN
5.	RETENTION BASIN
5.1	STORM DRAIN PROFILES
6.	INLET DETAILS
7.	OUTLET STRUCTURES
8.	LAILA H. LANE PLAN & PROFILE
9.	SARAH H. CIRCLE PLAN & PROFILE
10.	SARAH H. CIRCLE PLAN & PROFILE
11.	SARAH H. CIRCLE PLAN & PROFILE
12.	NOUR H. WAY PLAN & PROFILE
13.	NAZHA H. & JAMILA H. WAY PLAN & PROFILE
13.1	DECELERATION LANES
14.	SITE DETAILS
15.	SIGNING AND ILLUMINATION PLAN
16.	SIGNING AND ILLUMINATION DETAILS
17.	RETAINING WALL DETAIL
18.	STORM WATER POLLUTION PREVENTION PLAN
19.	STORM WATER POLLUTION PREVENTION PLAN

DEVELOPMENT SERVICES DEPARTMENT
SITE PLAN REVIEW
Reviewed For Conformance For Conditions Related To:

- Demolition Only
- Grading & Drainage
- Wheelchair Ramps
- On Site Parking Layout
- Sidewalks
- Driveways
- Retaining Rock Walls
- On-Site Ponding of Storm Waters

Contractor Must Call 24 Hours Prior To Construction For Inspection
BY DATE 2/12/2008
DECELERATION LANE ON ZARAGOZA MODIFICATION ONLY.

MOORE NORDELL KROEGER ARCHITECTS
7170 WESTWIND DR. SUITE 105
El Paso, Texas 79912-1726
T.915.587.8023 F.915.587.0985
email mnkarchitects.com

ESSCO INTERNATIONAL

SLI ENGINEERING, INC.
CIVIL ENGINEERS
LAND SURVEYORS
LAND PLANNERS
6500 WESTWIND DRIVE
EL PASO, TEXAS
(915) 584-4457

2/11/08